

# FLINTSHIRE COUNTY COUNCIL

## PROPOSED LOCATION OF A NEW BUS STOP

**NOTICE** is hereby given that the Flintshire County Council, proposes to locate a bus stop:-

- a) On Knowle Lane, Buckley at the location as described in the Schedule to this Notice.

**Reason for Proposal:** The existing double yellow line waiting restrictions outside Mountain Lane School were implemented to prevent obstructive parking and to maintain the safe and free flow of traffic. Following a review of current transport arrangements and road safety considerations, it is proposed to remove a section of these restrictions to facilitate the installation of formal bus stop with clearway markings.

The usual prohibition of vehicles stopping, waiting, loading and unloading within the bus stop will apply.

A copy of this Notice and a plan showing the road affected by the proposal, may be inspected during normal opening hours at Buckley Connects Centre, Buckley Library, The Precinct, Buckley, Flintshire, CH7 2EF. The documents will also be available to be viewed on our website at [www.Flintshire.gov.uk](http://www.Flintshire.gov.uk) > Resident > Roads, Streets and Travel > Traffic Regulation Orders or you can request a copy of the documents by emailing [transportstrategyconsultation@flintshire.gov.uk](mailto:transportstrategyconsultation@flintshire.gov.uk) or by calling 01352701234.

Objections to the proposal, together with the grounds on which they are made, should be sent in writing to the undersigned by Friday 20<sup>th</sup> March 2026 or by emailing [transportstrategyconsultation@flintshire.gov.uk](mailto:transportstrategyconsultation@flintshire.gov.uk) quoting reference SS/TRO/JB/MLKL/BusStop

### SCHEDULE

#### Knowle Lane, Buckley No Stopping Except Buses

**Knowle Lane, Buckley** – Bus stop to be located in front of Mountain Lane School from the existing zebra crossing zig-zags in a northerly direction.

Dated this Friday 27<sup>th</sup> day of February 2026



Katie Wilby,  
Chief Officer (Streetscene and Transportation),  
Alltami Depot,  
Mold Road,  
Alltami,  
Mold.  
CH7 6LG

**FLINTSHIRE COUNTY COUNCIL**

**NOTICE OF PROPOSAL  
(KNOWLE LANE, BUCKLEY)  
(NO STOPPING ON SCHOOL KEEP CLEAR MARKINGS)  
(MONDAY- FRIDAY 8.00AM – 5.00.PM)**

**NOTICE** is hereby given that Flintshire County Council in exercise of its powers under the Road Traffic Regulation Act 1984, propose to introduce a 'School Keep Clear' restriction, of up to 43.560 metres in length on Knowle Lane, Buckley, on the south-east of the carriageway at the entrance to Mountain Lane School. Vehicles would be prohibited from stopping on the yellow zig-zag markings indicating the restriction between the hours of 8 a.m. and 5 p.m. on Mondays to Fridays inclusive.

A copy of this Notice, the proposed Order, together with a plan showing the length of roads to which the proposed Order relates and a statement of the Council's reasons for proposing to make the Order may be examined at Flintshire Connects, Buckley Connects, Buckley Library, The Precinct, Buckley, Flintshire, CH7 2EF during opening hours or they may be viewed on our website at [www.Flintshire.gov.uk](http://www.Flintshire.gov.uk) > Resident > Roads, Streets and Travel > Traffic Regulation Orders or you can request a copy of the documents by emailing [transportstrategyconsultation@flintshire.gov.uk](mailto:transportstrategyconsultation@flintshire.gov.uk) or by calling 01352701234.

Objections to the proposed Order, together with the grounds on which they are made, should be sent in writing to the undersigned by Friday 20<sup>th</sup> March 2026 or by emailing [transportstrategyconsultation@flintshire.gov.uk](mailto:transportstrategyconsultation@flintshire.gov.uk) quoting reference SKC/CP/MLKLB/2026.

Dated this 27<sup>th</sup> day of February 2026



---

Katie Wilby,  
Chief Officer (Streetscene and Transportation),  
Alltami Depot,  
Mold Road,  
Alltami,  
Mold.  
CH7 6LG.

---

**THE FLINTSHIRE COUNTY COUNCIL**

**KNOWLE LANE, BUCKLEY**

**(NO STOPPING ON SCHOOL KEEP CLEAR/CLEARWAY)**

**(MONDAY- FRIDAY 8.00AM – 5.00PM)**

**(PROHIBITION AND RESTRICTION OF WAITING**

**AND LOADING AND PARKING PLACES)**

**(CIVIL ENFORCEMENT AND CONSOLIDATION) (AMENDMENT  
NO. 75) ORDER 202X**

---

**Katie Wilby,**

**Chief Officer (Streetscene & Transportation),**

**Alltami Depot, Mold Road**

**Alltami, Mold.**

**CH7 6LG**

**THE FLINTSHIRE COUNTY COUNCIL**  
**KNOWLE LANE, BUCKLEY**  
**(NO STOPPING ON SCHOOL KEEP CLEAR/CLEARWAY)**  
**(MONDAY- FRIDAY 8.00AM – 5.00PM)**  
**(PROHIBITION AND RESTRICTION OF WAITING**  
**AND LOADING AND PARKING PLACES)**

**(CIVIL ENFORCEMENT AND CONSOLIDATION) (AMENDMENT NO. 75) ORDER 202X**

Flintshire County Council in exercise of its powers under sections 1 (1), 1(2), 2(1), 3, 3(2), 4(1) and 122 and Part III and IV of Schedule 9 of the Road Traffic Regulation Act 1984 (“the Act of 1984”) as amended, the Traffic Management Act 2004 (“the 2004 Act”) and of all other enabling powers and after consultation with the Chief Officer of Police in accordance with Part III of Schedule 9 to the Act of 1984, hereby makes the following Order:-

**SECTION 1 – PRELIMINARY**

**Citation and commencement**

1. This Order shall come into operation on the XX<sup>th</sup> XXXX 20XX and may be cited as The Flintshire County Council, Knowle Lane, Buckley (No Stopping on School Keep Clear/Clearway) (Monday- Friday 8.00am – 5.00pm) (Prohibition and Restriction of Waiting and Loading and Parking Places) (Civil Enforcement and Consolidation) (Amendment No. 75) Order 202X.
2. With effect from the date set out in Article 2 above, Map Schedules AT93 Sheet Revision No: 4, replaces Map Schedules AT93 Sheet Revision No: 3 respectively and all other map schedules together with the before mentioned map schedules and plans referred to in the Schedule to this Order are incorporated into The Flintshire County Council (Prohibition and Restriction of Waiting and Loading and Parking Places) (Civil Enforcement and Consolidation) Order 2013.
3. The interpretation Act 1978 shall apply for the interpretation on this Order as it applies for the interpretation of an Act of Parliament.

4. In this Order, except where otherwise stated, any reference to a numbered Article or Schedule is a reference to the Article or Schedule bearing that number and any reference to a plan is reference to a plan incorporated into this Order.

**SCHEDULE**

**No Stopping on School Keep Clear**

**(Monday- Friday 8.00am – 5.00pm)**

**Knowle Lane Buckley**

<b><u>Road Name</u></b>	<b><u>Map Schedule</u></b>	<b><u>Sheet Revision</u></b>
Knowle Lane	AT93	4 (which revokes revision Sheet 3 from the 2013 Order

**THE COMMON SEAL** of )  
**FLINTSHIRE COUNTY COUNCIL** )  
was hereunto affixed )  
this XX<sup>th</sup> day of June 202X )  
in the presence of:- )

**CHAIRMAN**

**CHIEF OFFICER (GOVERNANCE)**

**LEGAL SERVICES MANAGER**


**SENIOR SOLICITOR**

**NOTICE OF PROPOSAL**  
**(KNOWLE LANE, BUCKLEY)**  
**(NO STOPPING ON SCHOOL KEEP CLEAR MARKINGS)**  
**(MONDAY- FRIDAY 8.00AM – 5.00.PM)**

**Statement of Reasons for Proposing to Make the Order**


Complaints have been received in relation to obstructive parking particularly at school peak times in the area around the entrances to Mountain Lane School, The Council therefore proposes to introduce a No stopping on School Keep Clear marking restriction. The purpose of providing School Keep Clear markings is to keep the space outside of schools free from parked vehicles so that children can be seen more easily when crossing the road.

**The proposals are detailed in the Public Notice and in the proposed Order**

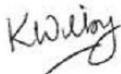

---

Katie Wilby,  
Chief Officer (Streetscene and Transportation),  
Alltami Depot,  
Mold Road,  
Alltami,  
Mold.  
CH7 6LG.  
Friday 27<sup>th</sup> February 2026.

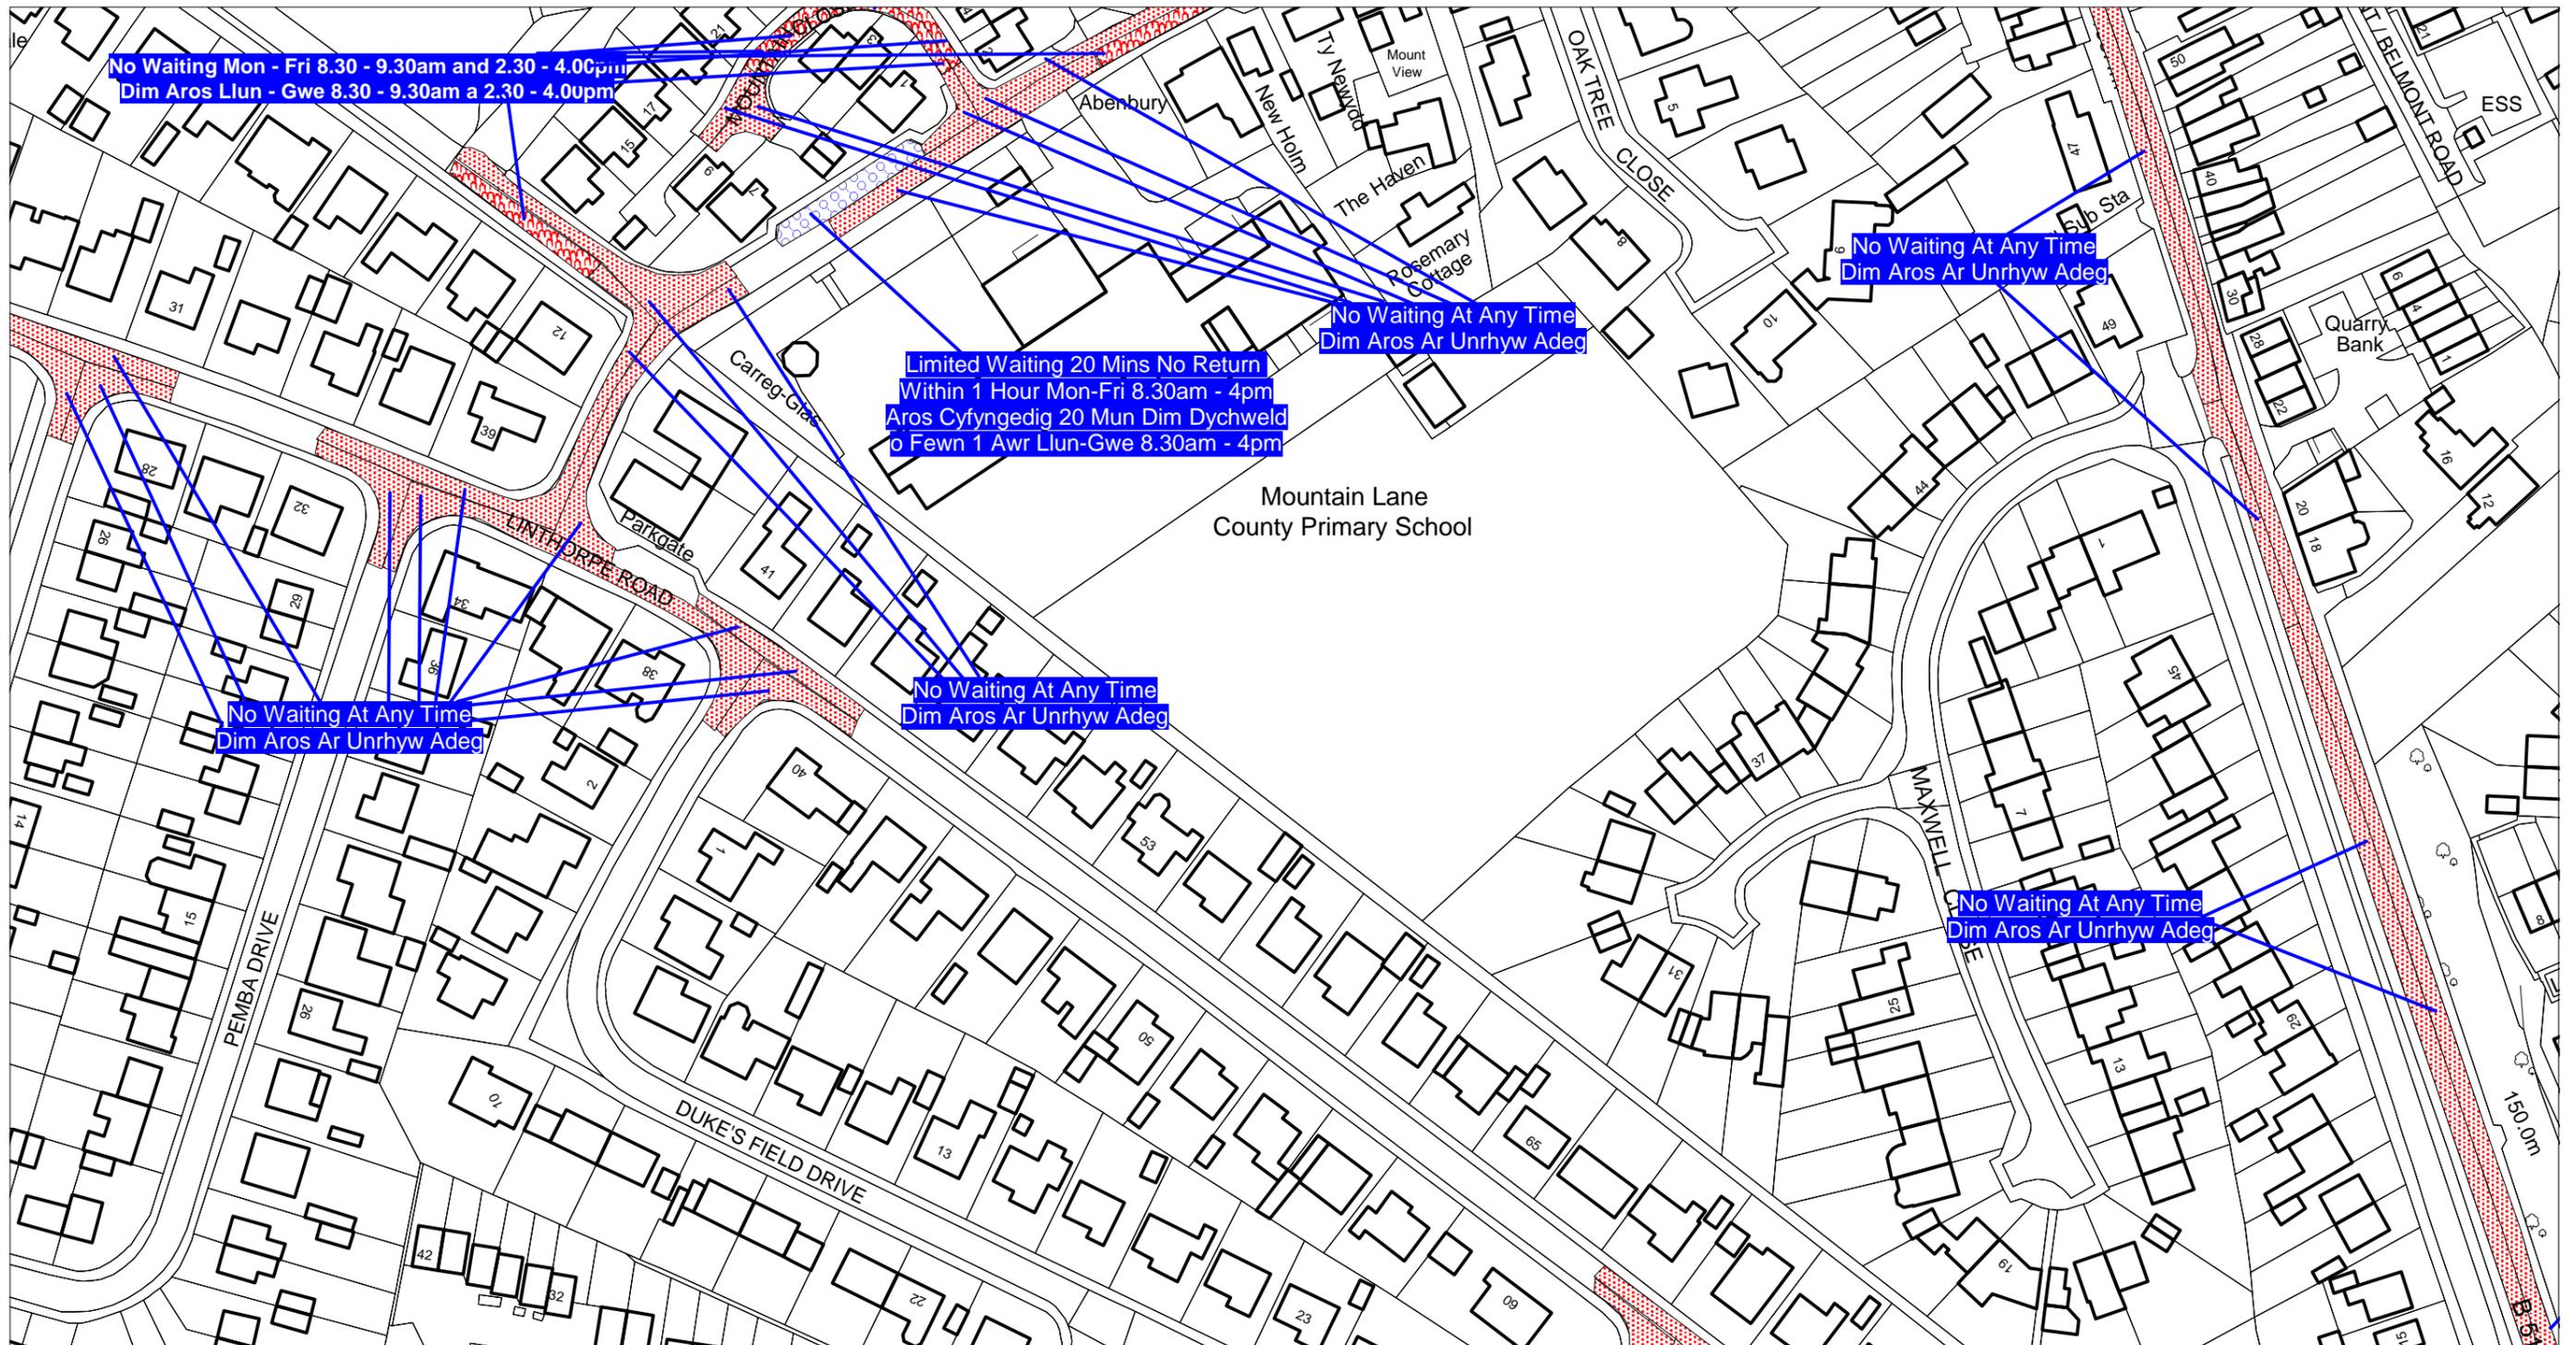

Scale: 1:1250

Graddfa: 1:1250

This map is reproduced from Ordnance Survey material with the permission of Ordnance Survey on behalf of the Controller of Her Majesty's Stationary Office ©Crown Copyright. Unauthorised reproduction infringes Crown Copyright and may lead to prosecution or civil proceedings. Licence No. 100023386


**The Flintshire County Council**  
**(Prohibition and Restriction of Waiting and Loading and Parking Places)**  
**(Civil Enforcement and Consolidation) (Amendment No 26) Order 2019**

Atgynhychir y map hwn o ddeunydd yr Ordnance Survey gyda chaniatad yr Ordnance Survey ar ran Rheolwr Llyfrfa Ei Mawrhydi ©Hawlfraint y Goron. Mae atgynhychu heb ganiatad yn torri hawlfraint y Goron a gall hyn arwain at erlyniad neu achos sifil. Rhif trwydded 100023386

**Gorchymyn Cyngor Sir Y Fflint**  
**(Gwahardd a Chyfyngu Aros a Llwytho a Mannau Parcio)**  
**(Gorfodi Sifil a Chydygfynerthu) (Gwelliant 26) 2019**

Flintshire County Council  
Environment Directorate  
County Hall  
Mold  
CH7 6NF

Cyngor Sir Y Fflint  
Cyfarwyddiaeth yr Amgylchedd  
Neuadd Y Sir  
Yr Wyddgrug  
CH7 6NF

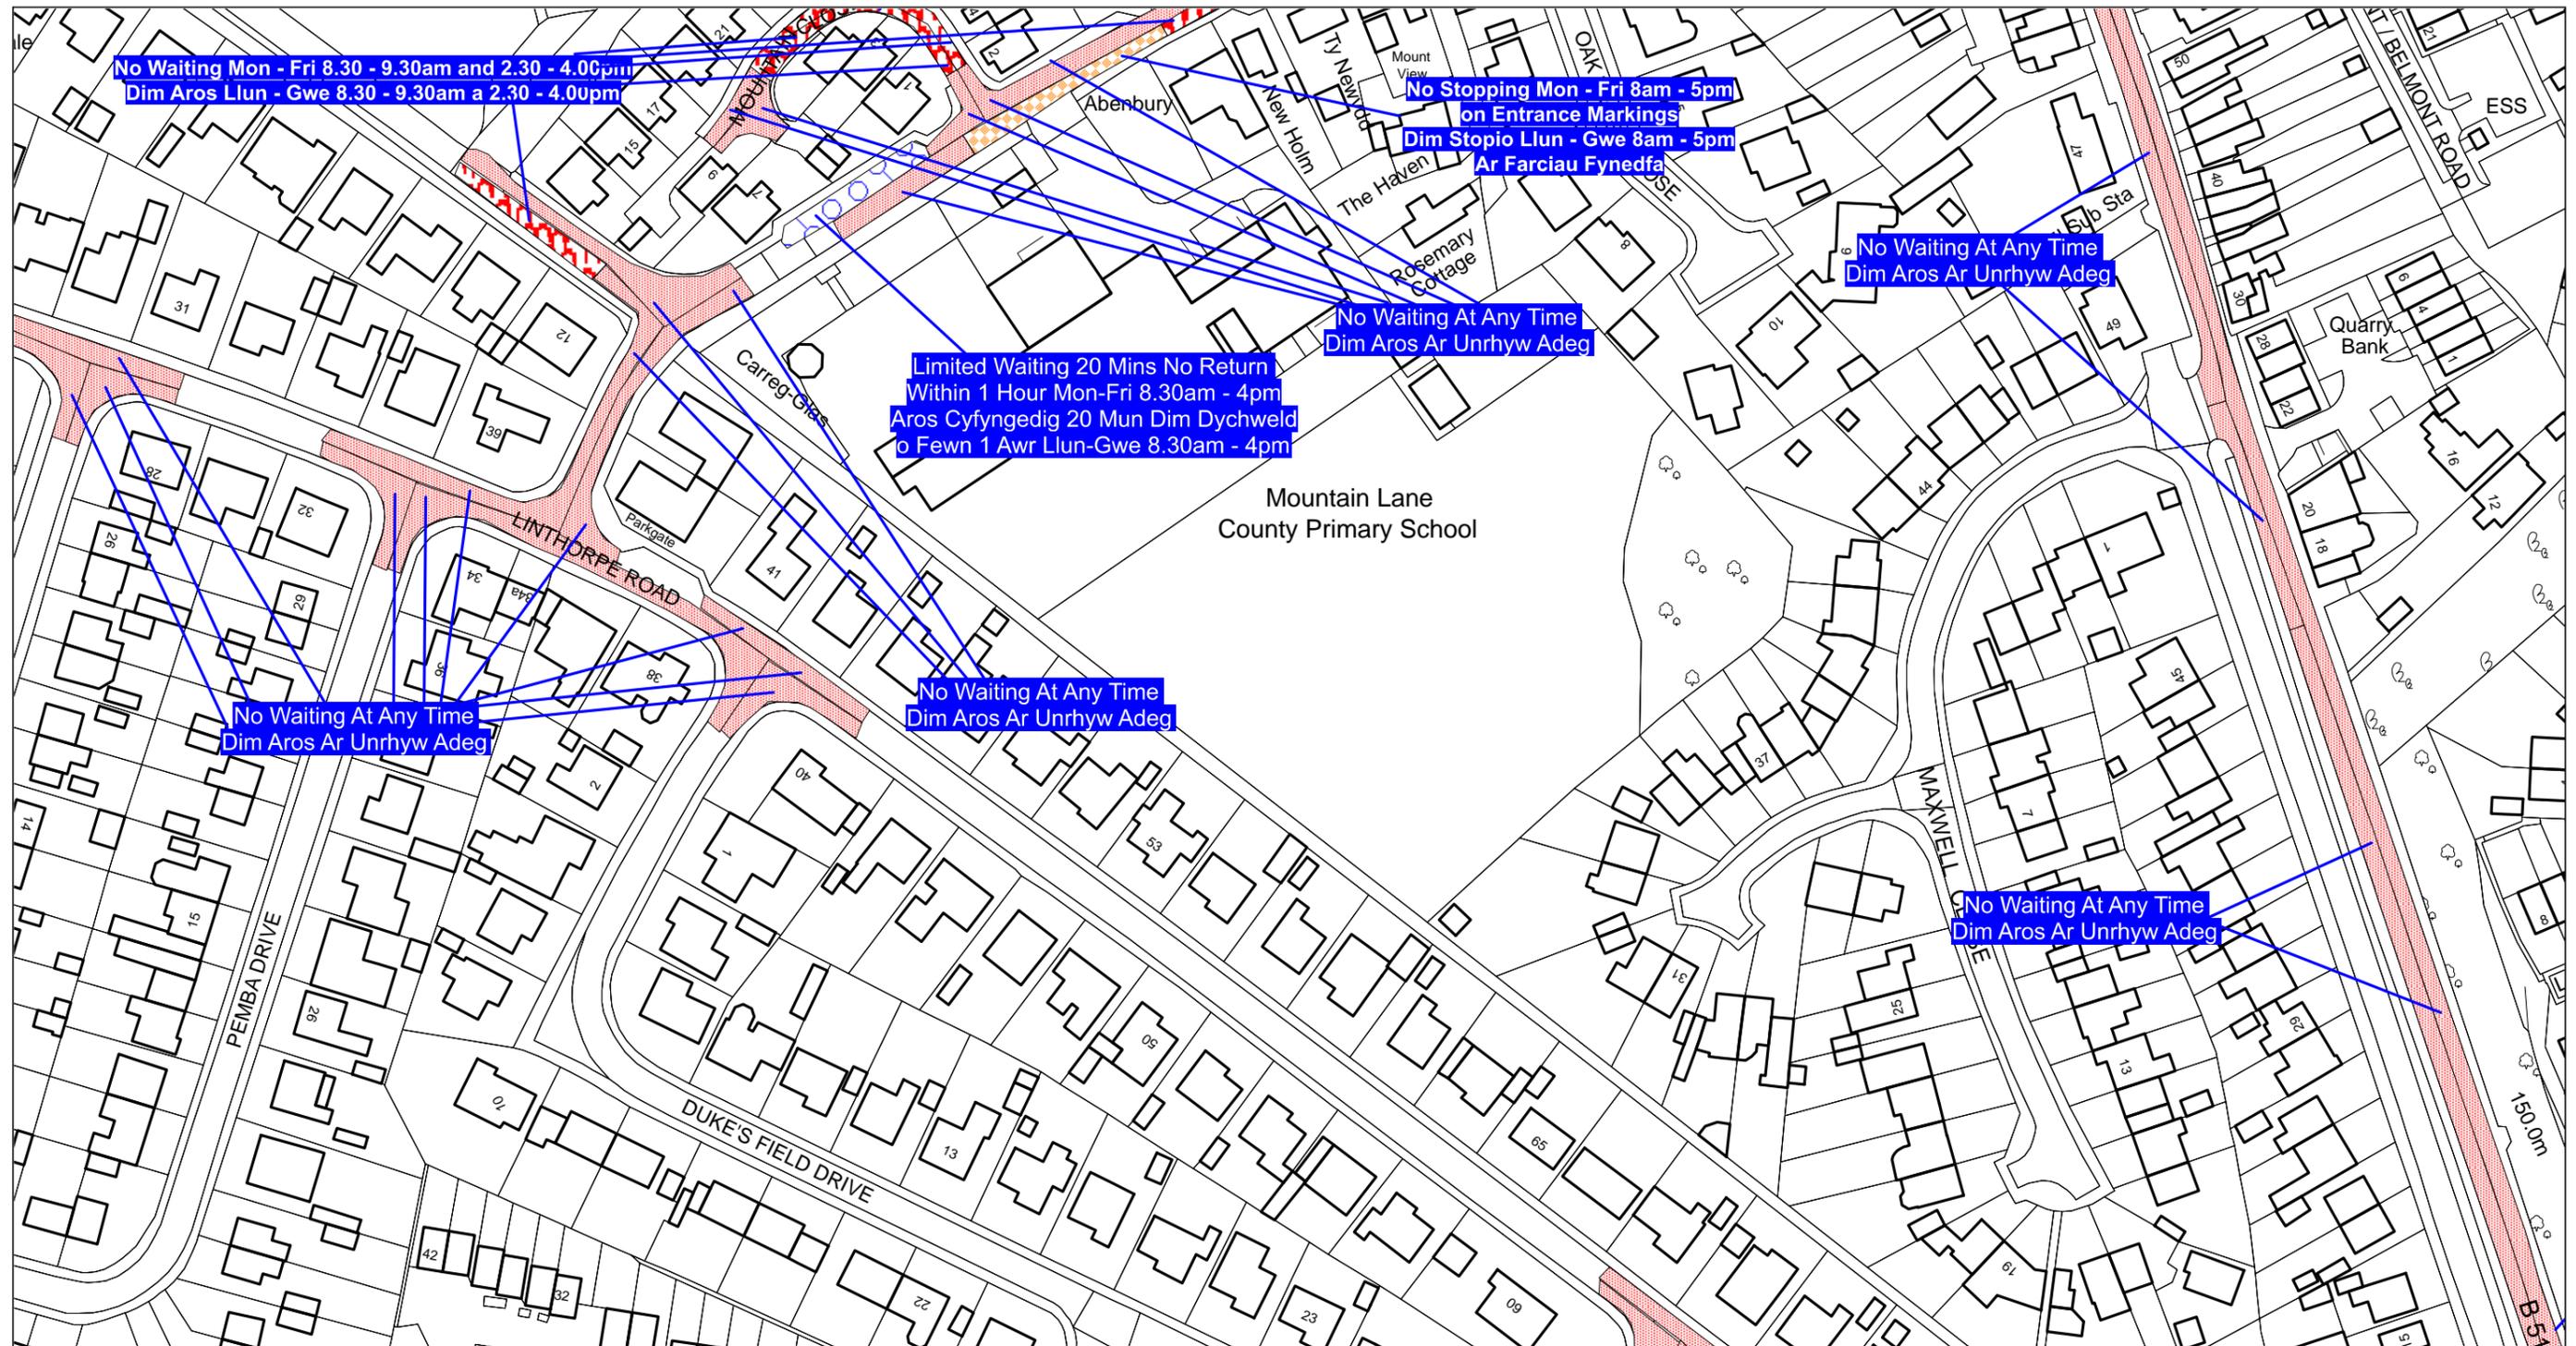

Scale: 1:1250

Graddfa: 1:1250

This map is reproduced from Ordnance Survey material with the permission of Ordnance Survey on behalf of the Controller of Her Majesty's Stationary Office ©Crown Copyright. Unauthorised reproduction infringes Crown Copyright and may lead to prosecution or civil proceedings. Licence No. 100023386


**The Flintshire County Council**  
**(Prohibition and Restriction of Waiting and Loading and Parking Places)**  
**(Civil Enforcement and Consolidation) (Amendment No 75) Order 202X**

Flintshire County Council  
Environment Directorate  
County Hall  
Mold  
CH7 6NF



Atgynhychir y map hwn o ddeunydd yr Ordnance Survey gyda chaniatad yr Ordnance Survey ar ran Rheolwr Llyfrfa Ei Mawrhydi ©Hawlfraint y Goron. Mae atgynhychu heb ganiatad yn torri hawlfraint y Goron a gall hyn arwain at erlyniad neu achos sifil. Rhif trwydded 100023386

**Gorchymyn Cyngor Sir Y Fflint**  
**(Gwahardd a Chyfyngu Aros a Llwytho a Mannau Parcio)**  
**(Gorfodi Sifil a Chydyfnerthu) (Gwelliant 75 202X)**

Cyngor Sir Y Fflint  
Cyfarwyddiaeth yr Amgylchedd  
Neuadd Y Sir  
Yr Wyddgrug  
CH7 6NF

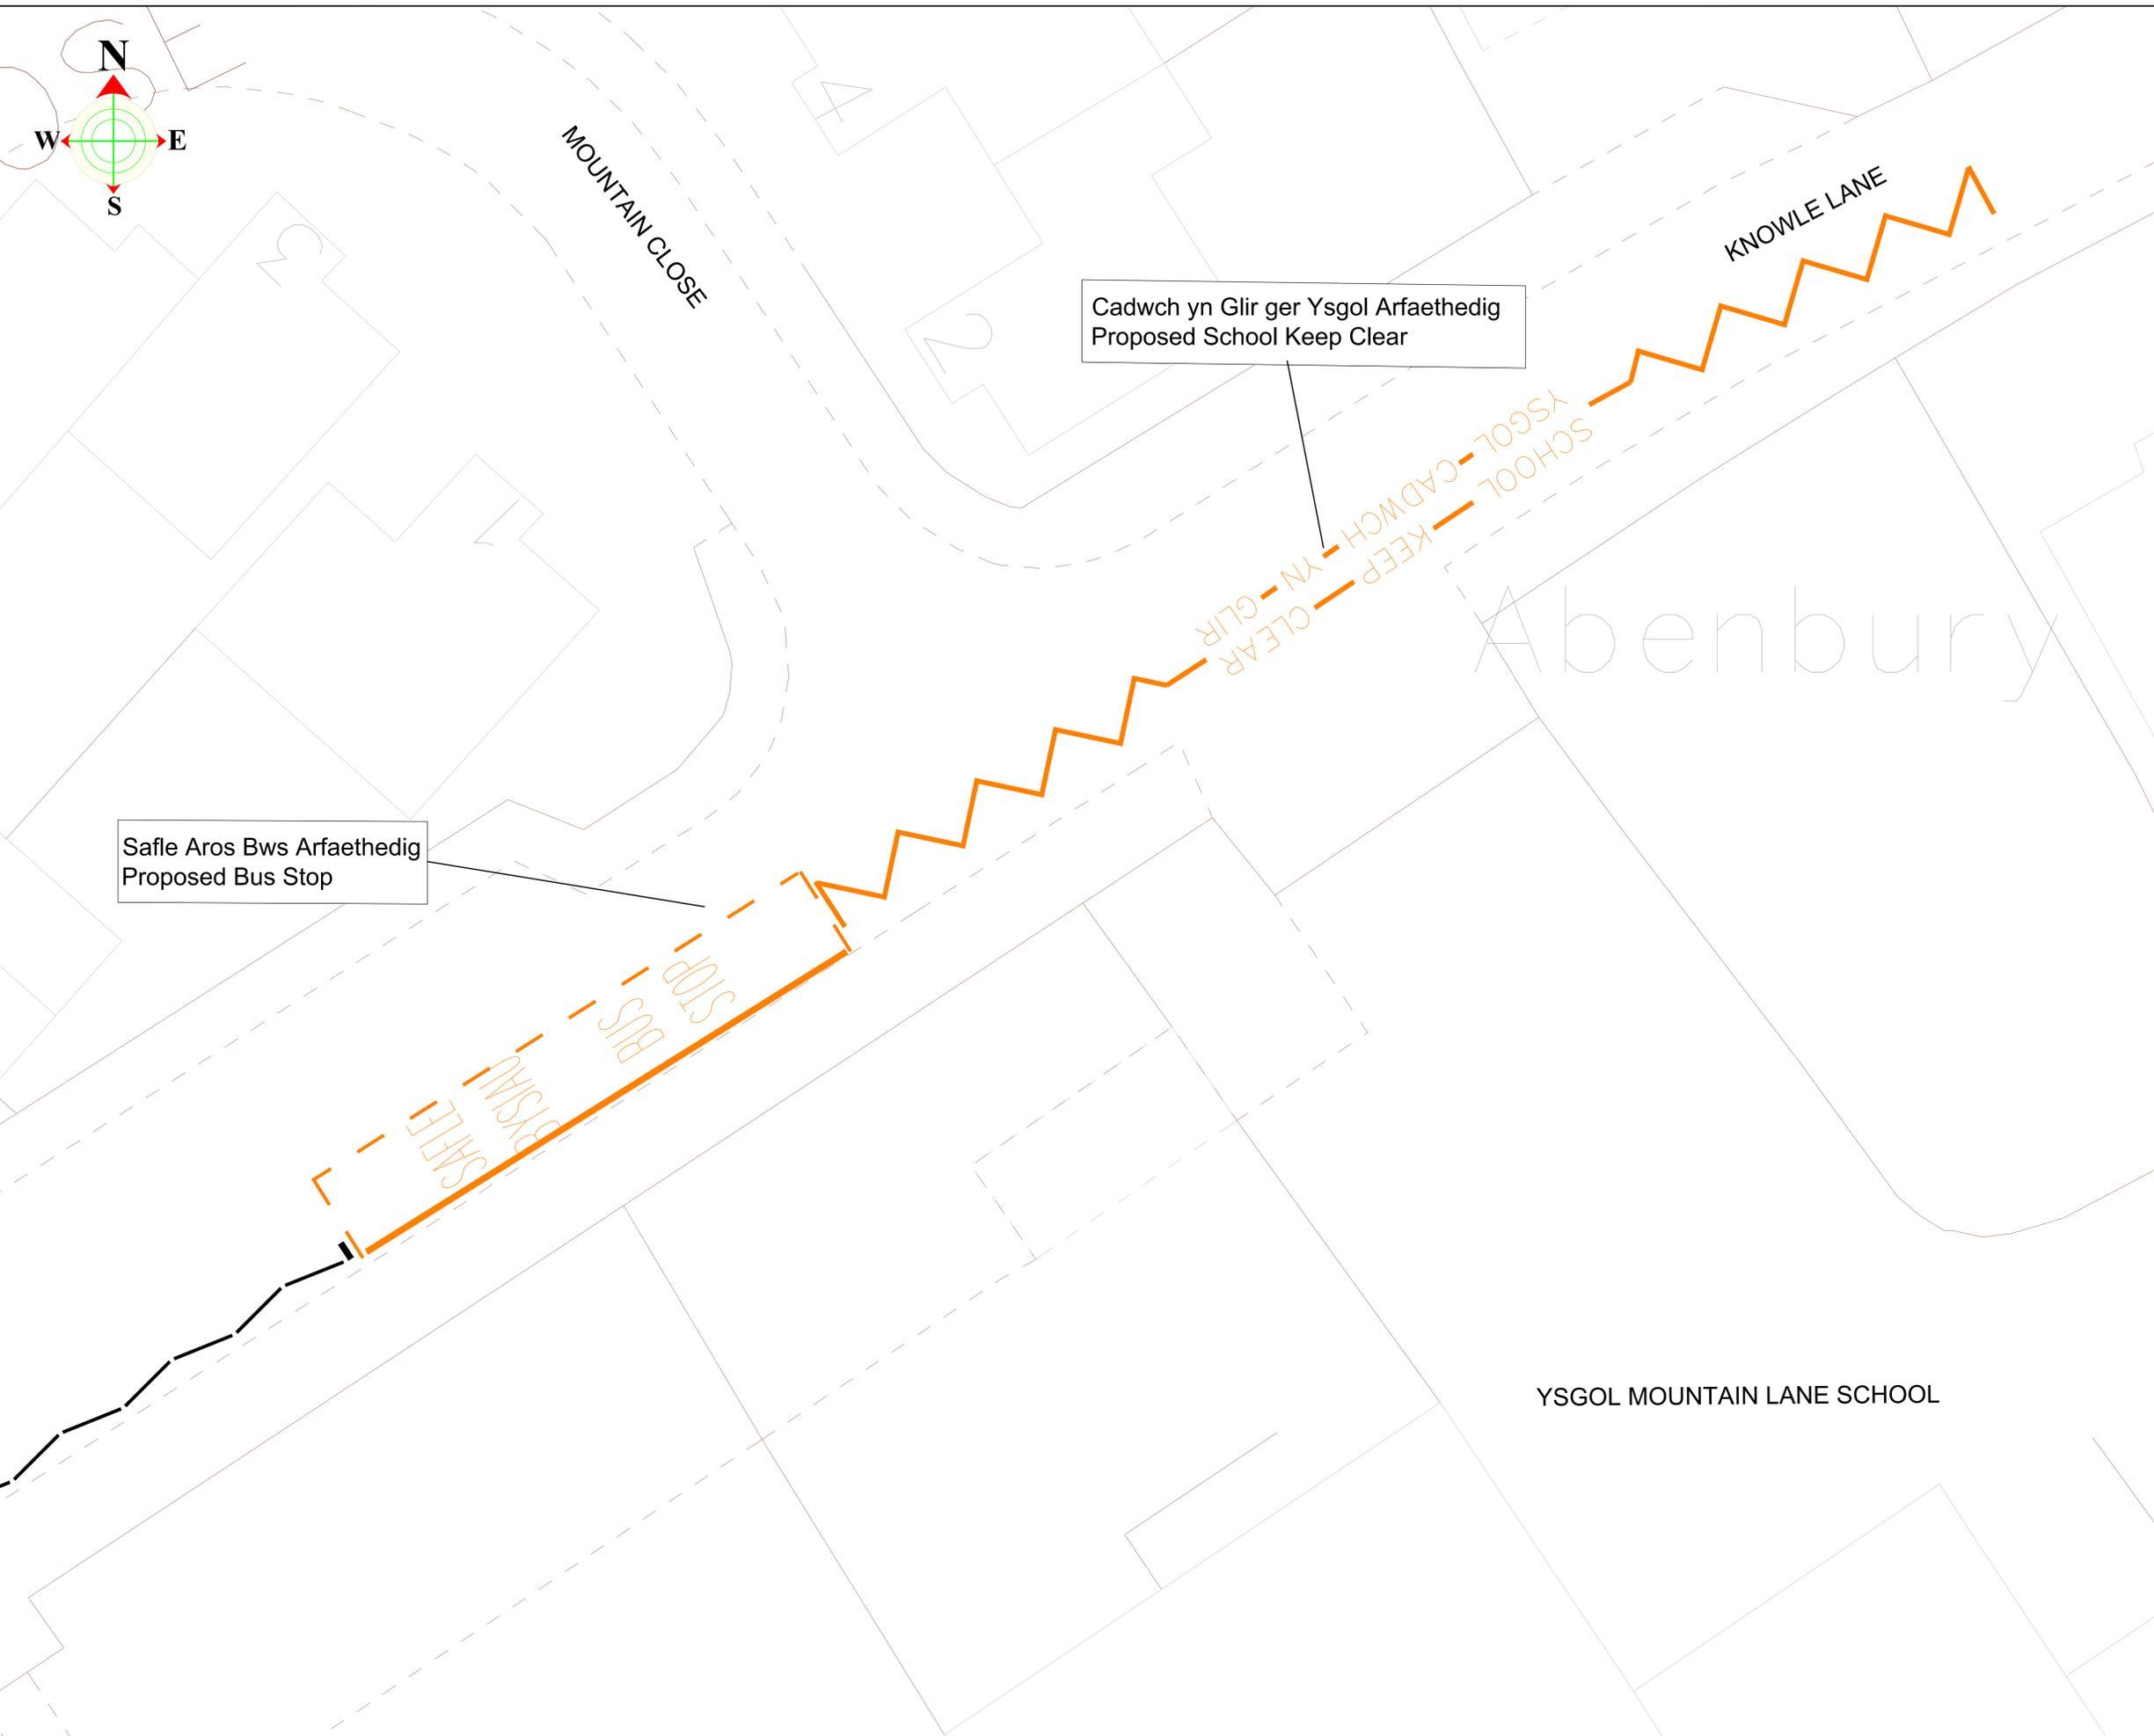

- Notes:**
- Proposed 43560m School Keep Clear Carriageway Marking Diag. 1027.1**  
Proposed 43560m School Keep Clear Carriageway Marking to Diag No.1027.1.To be Positioned centered to Gateway.
  - Proposed Bus Stop Marking - Detail B.**  
Proposed Bus Stop Carriageway Marking to diag. No. 1025.1 to be placed on carriageway opposite to the Cross Keys House. Refer to Detail B.
  - Proposed Bus Stop Sign Assembly - Detail C.**  
Proposed Bus Stop Sign Assembly 1 to diag. No. 974 to be placed Center of the New Bus Stop. Refer to Detail C.
  - All Signing has been specified in accordance with The Traffic Signs Regulations and General Directions 2016

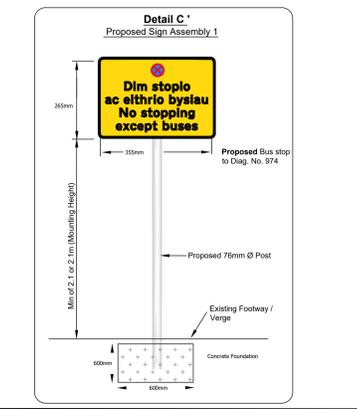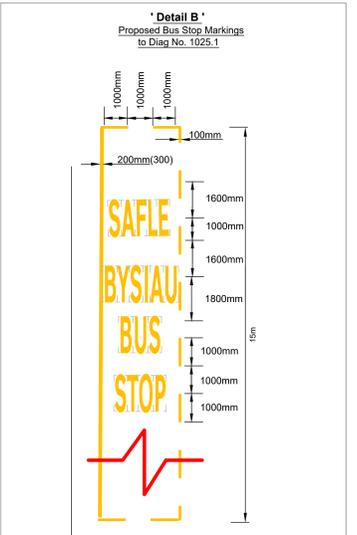

This map is reproduced from Ordnance Survey material with the permission of Ordnance Survey on behalf of the Controller of Her Majesty's Stationery Office.  
© Crown Copyright. Unauthorised reproduction infringes Crown Copyright and may lead to prosecution or civil proceedings.  
Licence number 100023386, Flintshire County Council, 2018.

CONSTRUCTION	WORKING	AS-BUILT
--------------	---------	----------

Plv/Rev.	Revision Details	Rev. by	Chk. by	Date

Project  
**Mountain Lane Primary School**  
 Knowle Lane, Buckley  
 Cadwch yn Glir ger Ysgol a Safle Aros Bws (Arfaethedig)  
**Proposed School Keep Clear and Bus Stop**  
 (Sheet 1 of 1)

Flintshire County Council - Environment Directorate, County Hall 1, Mold CH7 6NF	Telephone: 01352 704529	Sheet 1 of 1
Contact Name: Claire Parry	Fax No: 01352 70	Phase/Rev: P1
Drawn by: Nick Williams	Date: 22/01/2026	
Checked by: Claire Parry		
Scales at A0: 1:NTS	Drawing No: SS/SS/KLMS/	