

Notice of Proposal

THE FLINTSHIRE COUNTY COUNCIL

B5441 STATION ROAD, B5441 MOLD ROAD AND CHESTER ROAD EAST, QUEENSFERRY

PROPOSED NO LOADING AT ANY TIME AND GOODS VEHICLE LOADING ONLY RESTRICTIONS.

Flintshire County Council propose to make an Order in exercise of its powers under the Road Traffic Regulation Act 1984, the Traffic Management Act 2004, Part IV of Schedule 9 and all other enabling powers, the effect of which will be to amend The Flintshire County Council (Prohibition and Restriction of Waiting and Loading and Parking Places) (Civil Enforcement and Consolidation) Order 2013, so as to introduce:

(a) No Loading At Any Time restrictions:-

1. At the junction of Chester Road East, with the B5441 Station Road / Mold Road, Queensferry.
2. On the north easterly side of Chester Road East
3. On the south westerly side of Chester Road East
4. On the south easterly side of the B5441 Station Road, Queensferry.
5. On the south easterly side of the B5441 Mold Road, Queensferry.

(b) Goods Vehicle Loading Only Bays:-


1. On the north easterly side of Chester Road East, Queensferry, opposite the rear door to KFC.
2. On the south easterly side of the B5441 Station Road, Queensferry, outside numbers 8 and 10.

In all other respects the present provisions of the 'The Flintshire County Council (Prohibition and Restriction of Waiting and Loading and Parking Places) (Civil Enforcement and Consolidation) Order 2013' will remain in force.

A copy of the Notice, the proposed Order, plans showing the roads affected by the proposal and a statement of the Council's reasons for proposing to make the Order, may be inspected during normal opening hours at Flintshire Connects, Wepre Drive, Connah's Quay CH5 4HA. The documents will also be available to be viewed on our website at www.Flintshire.gov.uk > Resident > Roads, Streets and Travel > Traffic Regulation Orders or you can request a copy of the documents by emailing transportstrategyconsultation@flintshire.gov.uk or by calling 01352701234.

Objections to the proposed Order, together with the grounds on which they are made, should be sent in writing to the undersigned by Friday 23rd October 2026 or by emailing transportstrategyconsultation@flintshire.gov.uk quoting reference SS/TRO/JB/79.

Katie Wilby,
Chief Officer (Streetscene and Transportation),
Alltami Depot,
Mold Road,
Alltami,
Mold.
CH7 6LG.

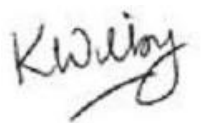

Dated this Friday 02nd October 2026

THE FLINTSHIRE COUNTY COUNCIL

**B5441 STATION ROAD, B5441 MOLD ROAD AND CHESTER
ROAD EAST, QUEENSFERRY**

**(PROHIBITION AND RESTRICTION OF WAITING
AND LOADING AND PARKING PLACES)**

**(CIVIL ENFORCEMENT AND CONSOLIDATION) (AMENDMENT
NO. 79) ORDER 202-**

**Katie Wilby,
Chief Officer (Streetscene & Transportation),
Alltami Depot, Mold Road
Alltami, Mold.
CH7 6LG**

THE FLINTSHIRE COUNTY COUNCIL

**B5441 STATION ROAD, B5441 MOLD ROAD AND CHESTER ROAD EAST,
QUEENSFERRY**

(PROHIBITION AND RESTRICTION OF WAITING

AND LOADING AND PARKING PLACES)

(CIVIL ENFORCEMENT AND CONSOLIDATION) (AMENDMENT NO. 79) ORDER 202-

Flintshire County Council in exercise of its powers under sections 1 (1), 2 (1)(2), 4 (2)(3) and Part IV of Schedule 9 of the Road Traffic Regulation Act 1984 (“the Act of 1984”) as amended, the Traffic Management Act 2004 (“the 2004 Act”) and of all other enabling powers and after consultation with the Chief Officer of Police in accordance with Part III of Schedule 9 to the Act of 1984, hereby makes the following Order:-

SECTION 1 – PRELIMINARY

Citation and commencement

1. This Order shall come into operation on the XXth XXX 202- and may be cited as The Flintshire County Council B5441 STATION ROAD, B5441 MOLD ROAD AND CHESTER ROAD EAST, QUEENSFERRY (Prohibition and Restriction of Waiting and Loading and Parking Places) (Civil Enforcement and Consolidation) (Amendment No. 79) Order 202-
2. With effect from the date set out in Article 1 above, Map Schedule BA77, Sheet Revision No: 2 replaces Map Schedule BA77 Sheet Revision 1 respectively and all other Map Schedules together with the before mentioned Map Schedules and plans referred to in the Schedules to this Order are incorporated into The Flintshire County Council (Prohibition and Restriction of Waiting and Loading and Parking Places) (Civil Enforcement and Consolidation) Order 2013.
3. The interpretation Act 1978 shall apply for the interpretation on this Order as it applies for the interpretation of an Act of Parliament
4. In this Order, except where otherwise stated, any reference to a numbered Article or Schedule is a reference to the Article or Schedule bearing that number and any reference to a plan is reference to a plan incorporated into this order.

SCHEDULE 1

No Loading At Any Time restrictions

Queensferry

Road Name	Map Schedule	Sheet Revision
B5441 Station Road	BA77	2 (which revokes revision Sheet 1 from the 2013 Order)
Chester Road East	BA77	2 (which revokes revision Sheet 1 from the 2013 Order)
B5441 Mold Road	BA77	2 (which revokes revision Sheet 1 from the 2013 Order)

SCHEDULE 2

Goods Vehicle Loading Only

Queensferry

Road Name	Map Schedule	Sheet Revision
B5441 Station Road	BA77	2 (which revokes revision Sheet 1 from the 2013 Order)
Chester Road East	BA77	2 (which revokes revision Sheet 1 from the 2013 Order)

THE COMMON SEAL of)
FLINTSHIRE COUNTY COUNCIL)
 was hereunto affixed)
 this xxth day of xxxx 202-)
 in the presence of:-)

CHAIRMAN

CHIEF OFFICER (GOVERNANCE)

LEGAL SERVICES MANAGER

SENIOR SOLICITOR

THE FLINTSHIRE COUNTY COUNCIL

**B5441 STATION ROAD, B5441 MOLD ROAD AND CHESTER ROAD EAST,
QUEENSFERRY**

**PROPOSED NO LOADING AT ANY TIME AND GOODS VEHICLE LOADING
ONLY RESTRICTIONS.**

Statement of Reasons for Proposing to Make the Order

Flintshire County Council propose to introduce No Loading at Any Time restrictions (Double yellow strikes on kerbs) on sections of the B5441 Station Road, B5441 Mold Road and Chester Road East, Queensferry

The Introduction of the proposed restrictions, will ensure access is maintained, prevent obstructive parking, maintain visibility at the junction and allow for free-flowing traffic at these locations.

The County Council continues its responsibility to consider the provision of convenient and safe movement of motor vehicles and other traffic, and the proposed measures are aimed at ensuring that danger is minimised to all road users.


Chester Road East and B5441 Station Road, Goods Vehicle Loading Bays

Flintshire County Council propose to introduce Goods Vehicle Loading Bays on sections of Chester Road East and the B5441 Station Road, Queensferry.

The Introduction of the proposed Goods Vehicle Loading Only Bay, will provide a dedicated space for goods vehicles to unload and load goods to and from the surrounding businesses. The bay on Chester Road East, can also accommodate funeral vehicles (a hearse) requiring access to the nearby church.

The proposals are detailed in the Public Notice and in the proposed Order


Katie Wilby,
Chief Officer (Streetscene and Transportation),
Alltami Depot,
Mold Road,
Alltami,
Mold.
CH7 6LG.
Friday 02nd October 2026.

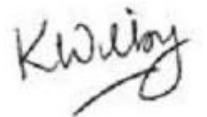

AREA CODE:BA77
COD ARDAL:BA77




Sheet Revision No: 2
Rhif Adolgiad Y Ddalen: 2
Sheet active from: XX XXXXX 202X
Dalen yn weithredol o: XX XXXXX 202X

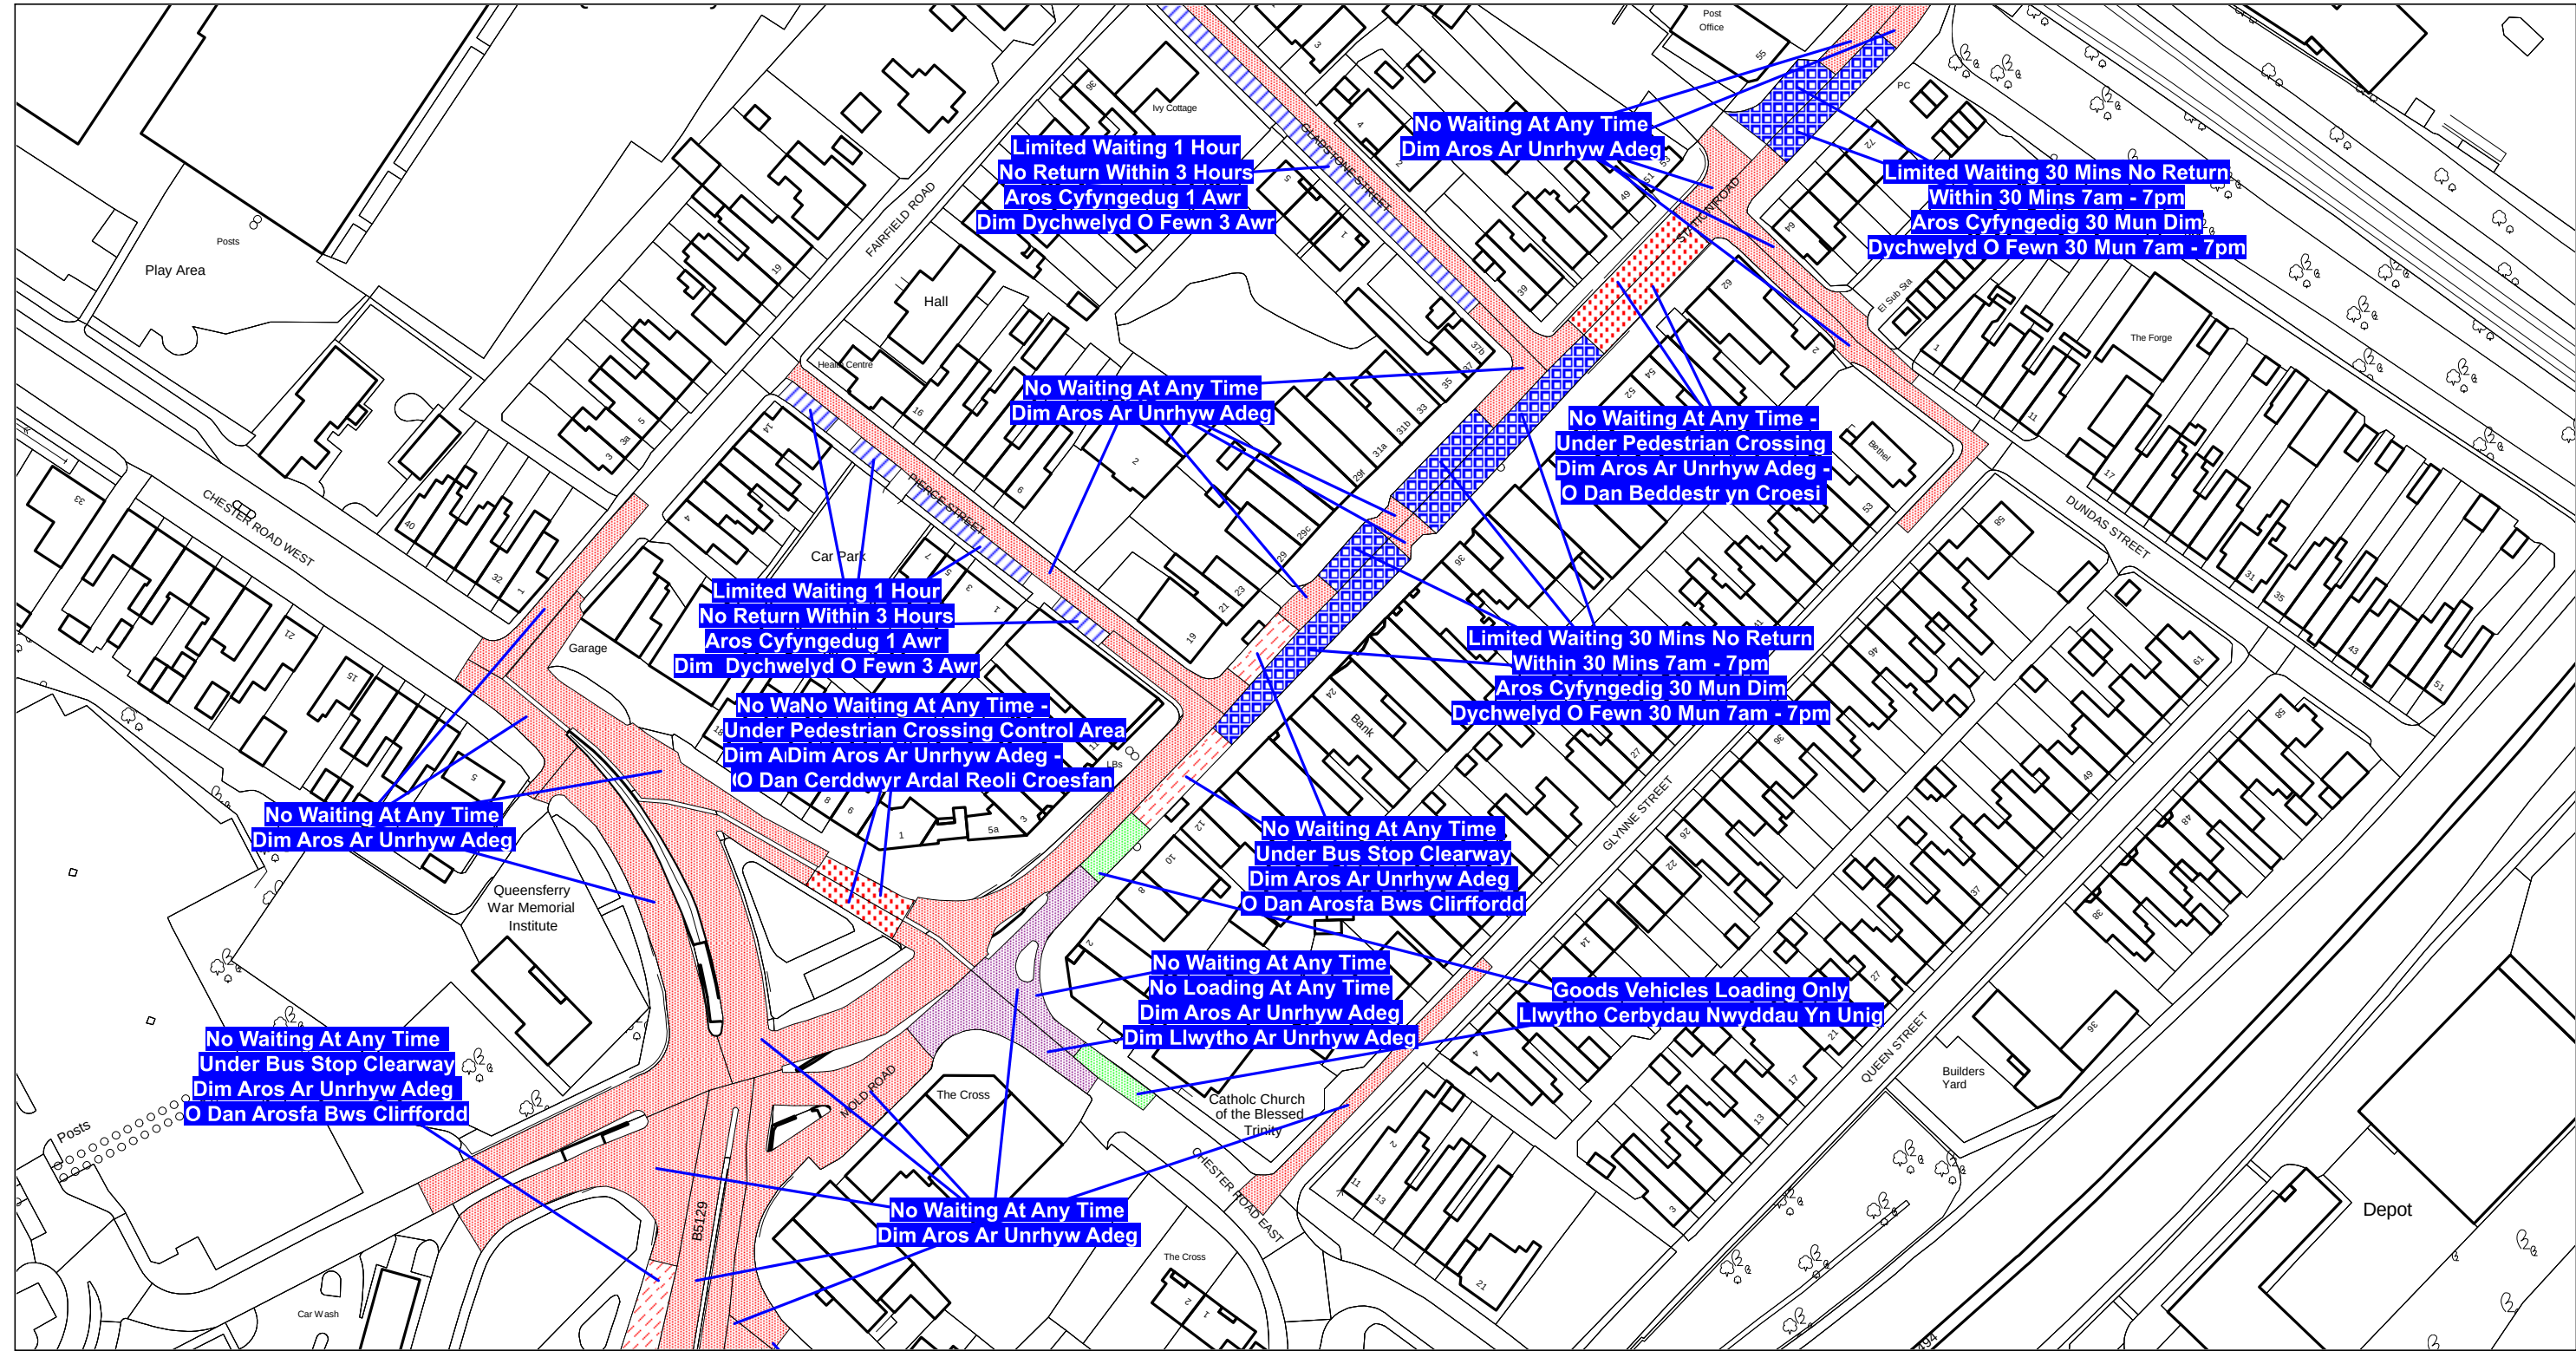

COD ARDAL:BA77
AREA CODE:BA77



Sheet Revision No: 1
Rhif Adolgiad Y Ddalen: 1
Sheet active from: 1 October 2013
Dalen yn weithredol o: 1 Hydref 2013

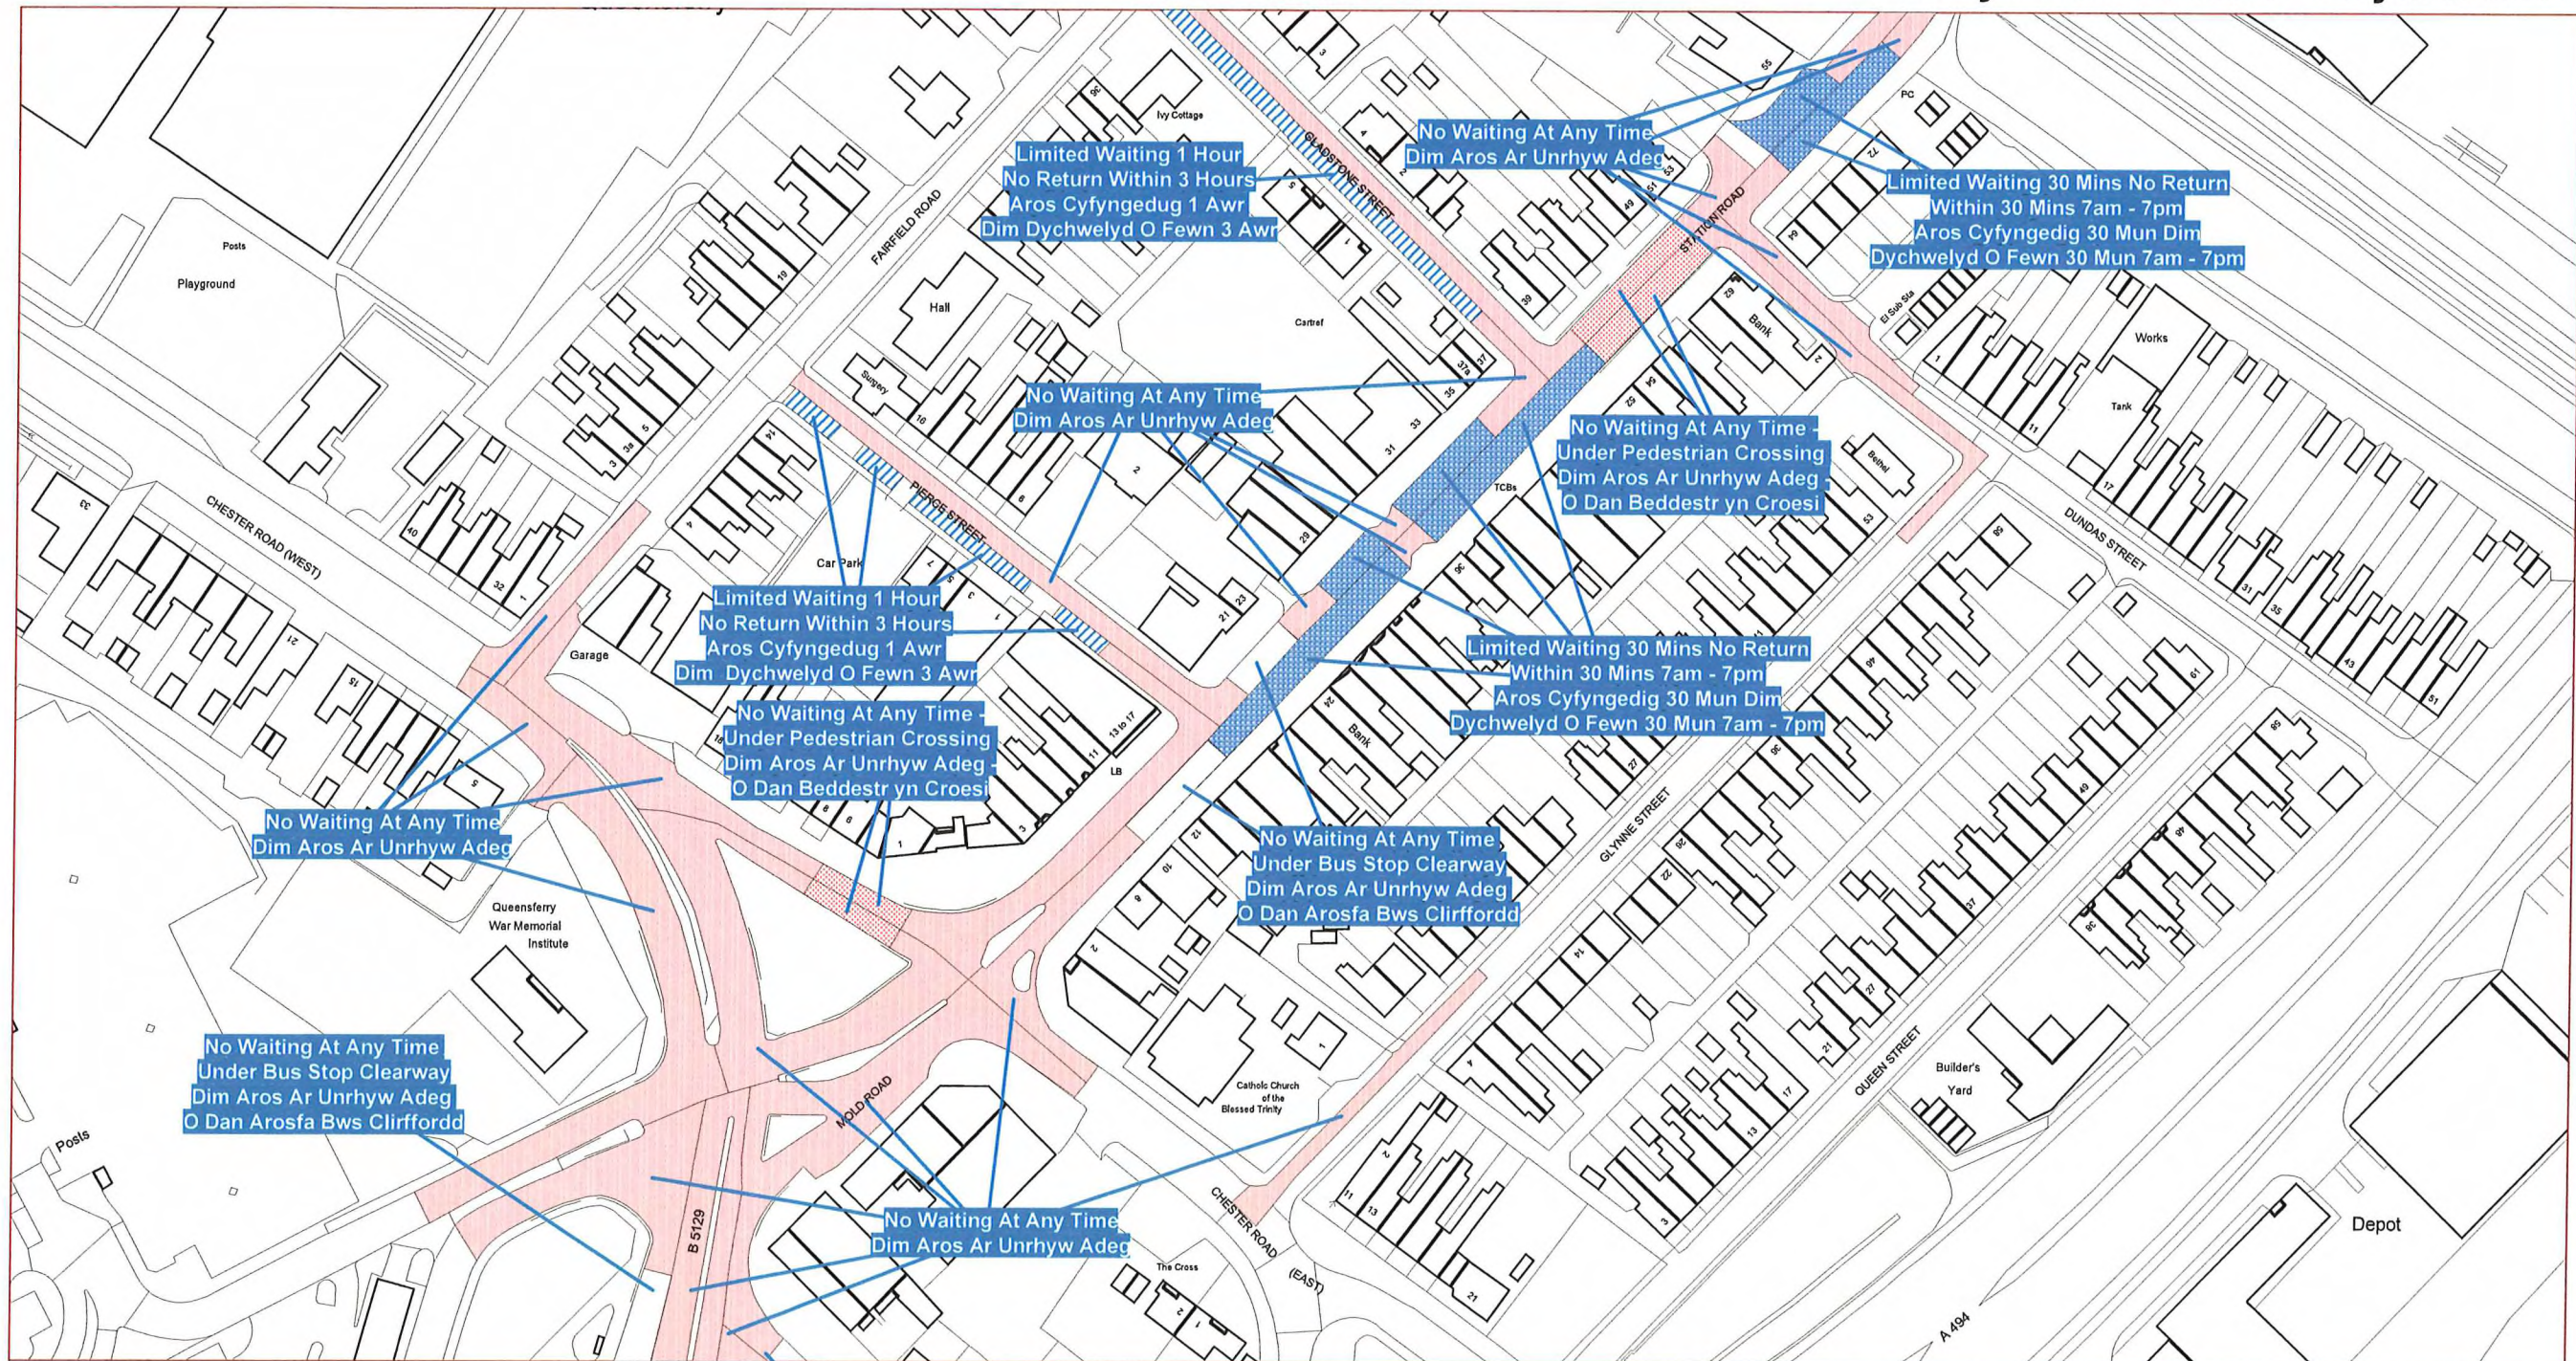

Scale: 1:1250
Graddfa: 1:1250

This map is reproduced from Ordnance Survey material with the permission of Ordnance Survey on behalf of the Controller of Her Majesty's Stationary Office © Crown Copyright. Unauthorised reproduction infringes Crown Copyright and may lead to prosecution or civil proceedings. Licence No. 100023386


Atgynhychir y map hwn o ddeunydd yr Ordnance Survey gyda chaniatad yr Ordnance Survey ar ran Rheolwr Llyfrfa Ei Mawrhydi © Hawlfraint y Goron. Mae atgynhychu heb ganiatad yn torri hawlfraint y Goron a gall hyn arwain at erlyniad neu achos sifil. Rhif trwydded 100023386

The Flintshire County Council
(Prohibition and Restriction of Waiting and Loading and Parking Places)
(Civil Enforcement and Consolidation) Order 2013

Gorchymyn Cyngor Sir Y Fflint
(Gwahardd a Chyfyngu Aros a Llwytho a Mannau Parcio)
(Gorfodi Sifil a Chydgynferthu) 2013


Flintshire County Council
Environment Directorate
County Hall
Mold
CH7 6NF

Cyngor Sir Y Fflint
Cyfarwyddiaeth yr Amgylchedd
Neuadd Y Sir
Yr Wyddgrug
CH7 6NF

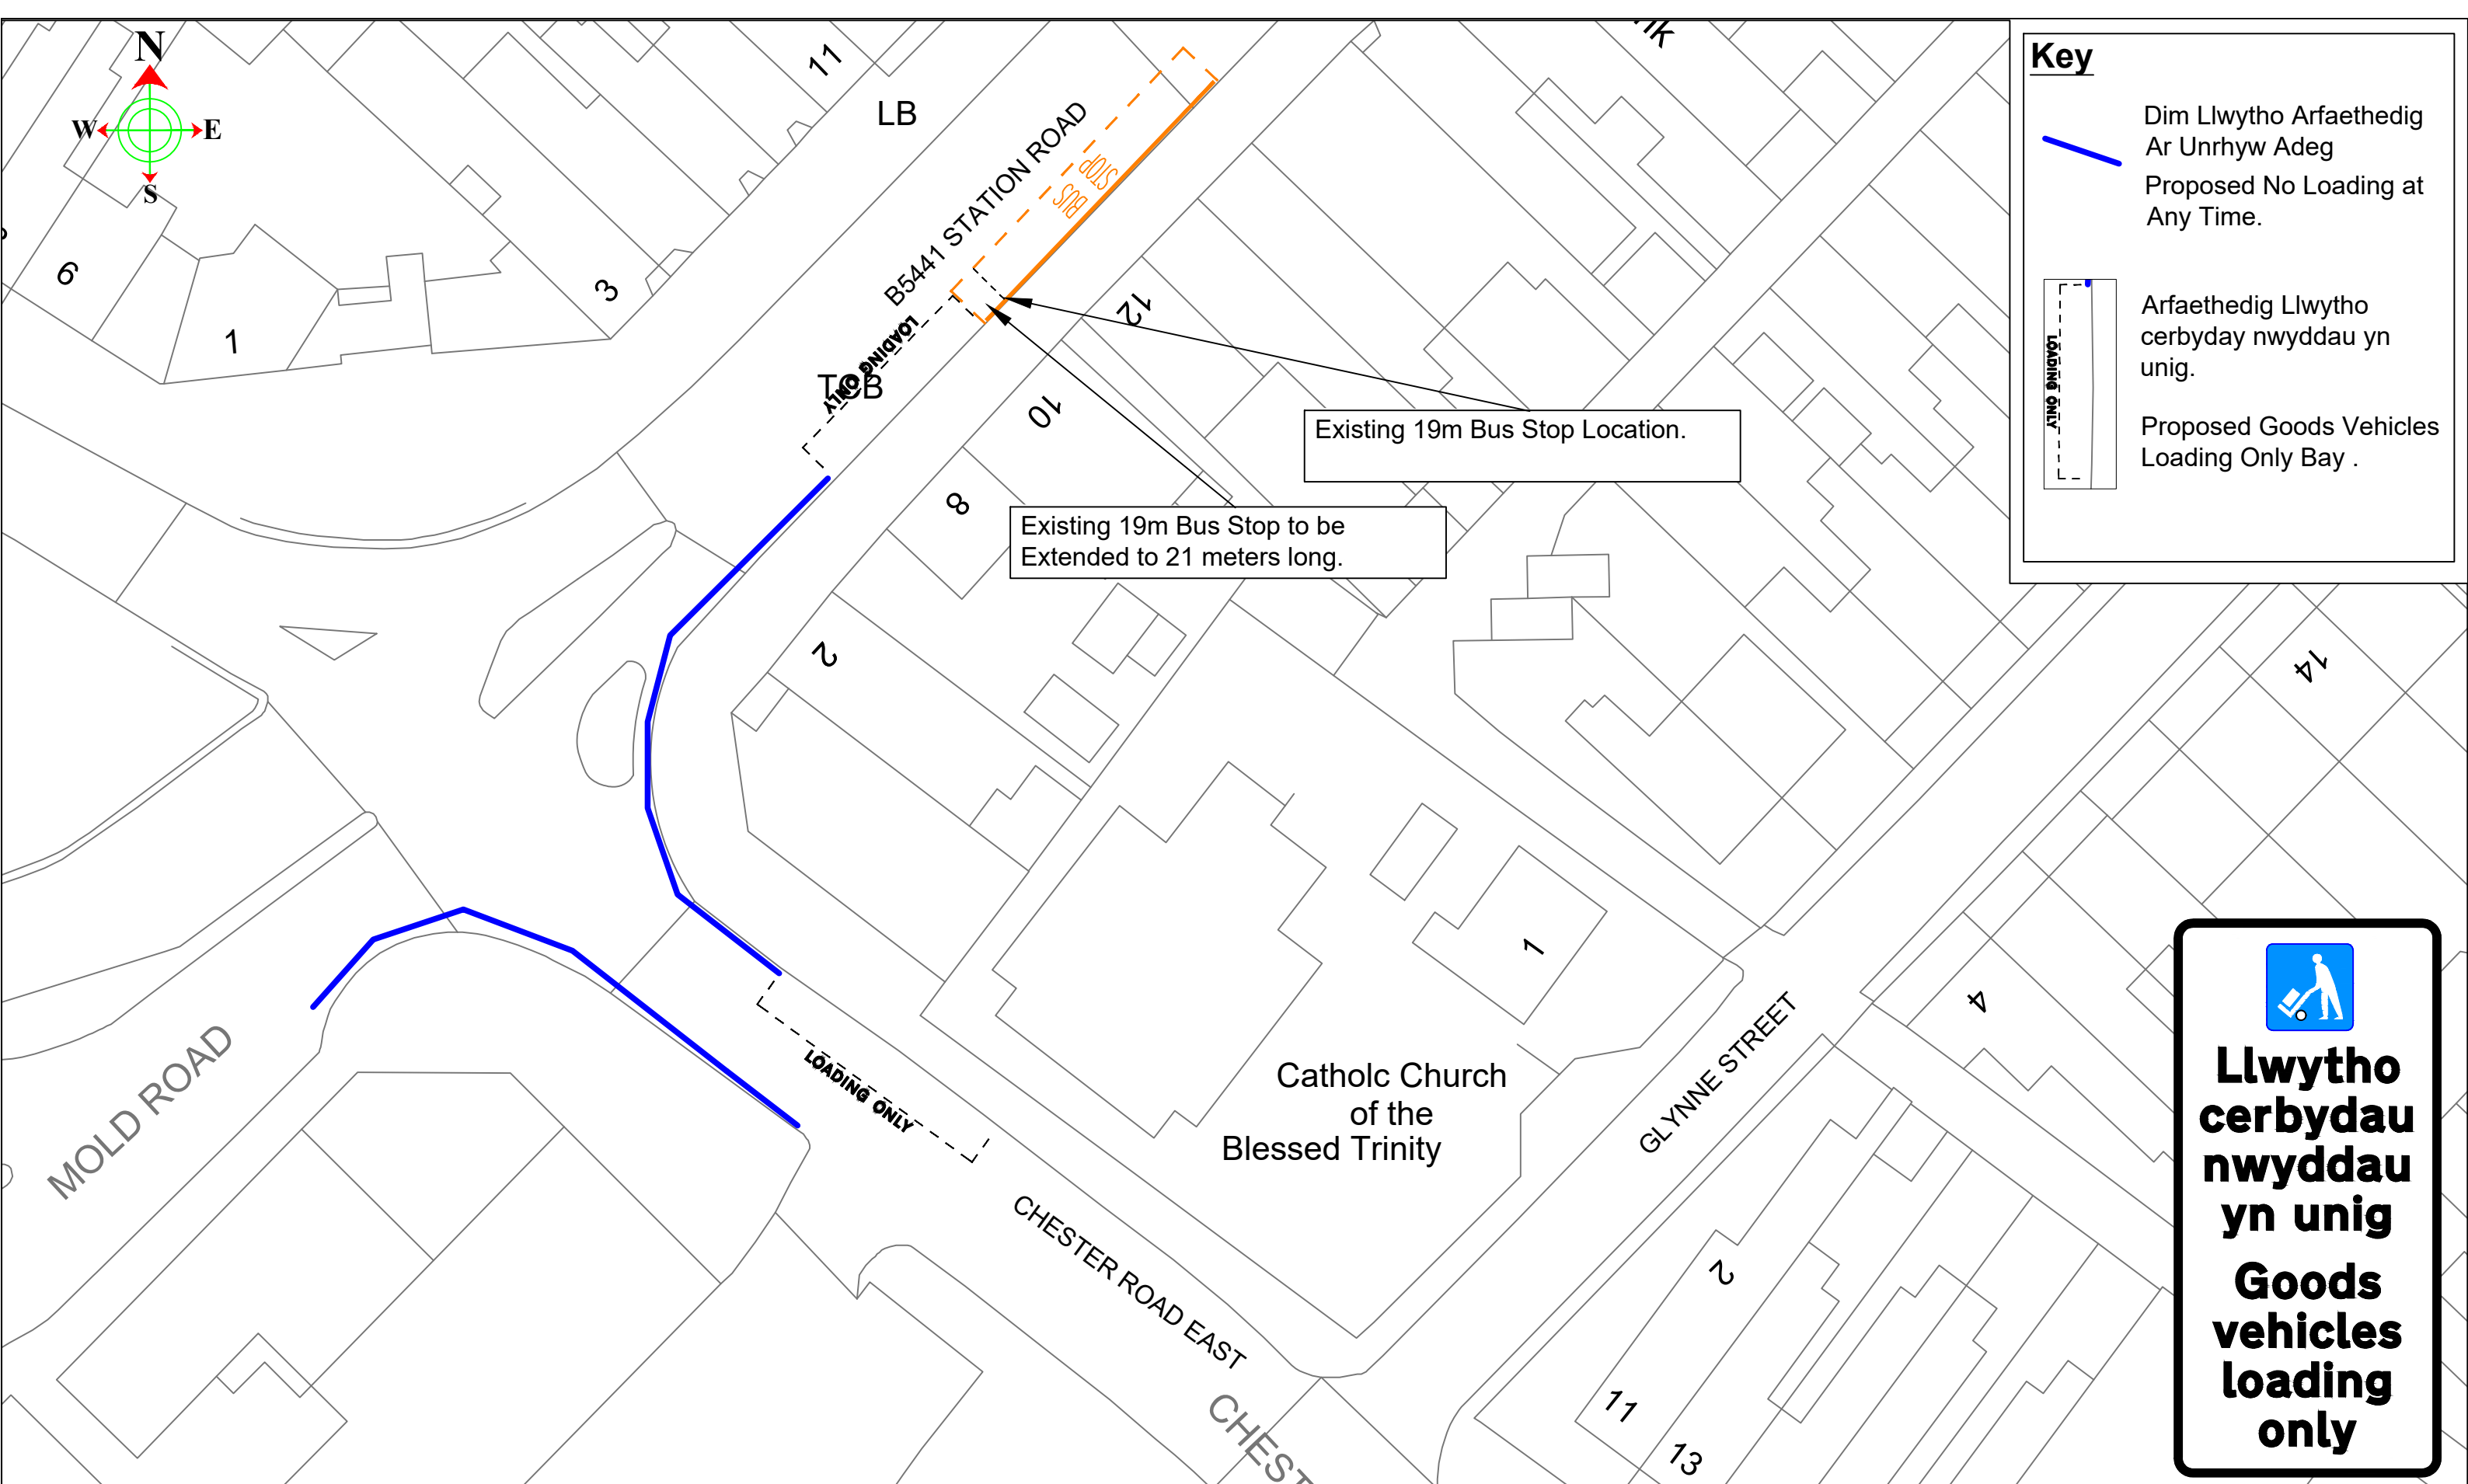

Key

 Dim Llwytho Arfaethedig Ar Unrhyw Adeg
Proposed No Loading at Any Time.

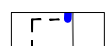 Arfaethedig Llwytho cerbyday nwyddau yn unig.
Proposed Goods Vehicles Loading Only Bay .



Llwytho cerbydau nwyddau yn unig
Goods vehicles loading only



Sir y Fflint
Flintshire
COUNTY COUNCIL

Katie Wilby
Chief Officer (Streetscene and Transportation).
Prif Swyddog (Gwasanaethau Stryda Thafnidiaeth).

County Hall, Mold, CH7 6NF
Neuadd y Sir, Yr Wyddgrug. CH7 6NF

STREETSCENE

This map is reproduced from Ordnance Survey material with the permission of Ordnance Survey on behalf of the Controller of Her Majesty's Stationery Office.
© Crown Copyright. Unauthorised reproduction infringes Crown Copyright and may lead to prosecution or civil proceedings.
Licence number 100023386.Flintshire County Council, 2018.

DRAWN BY:
NGW

CHECKED BY:
IB

SCALE:
1:1NTS @ A3

NAT. GRID REF:
331745
368305

PRELIMINARY	WORKING	AS-BUILT
AMENDMENTS:		DATE

Dim Llwytho Arfaethedig Ar Unrhyw Adeg a Llwytho cerbydau yn unig
Proposed No Loading at Any Time and Goods vehicles loading only

Queensferry

DRAWING NUMBER

HT/26/CREQ

00

P1